

換地図その2 (換地処分後の土地図)












記号	名称	備考
	施行地区区域界	
北中振三丁目	町名	
3000	地番: 宅地	田含む
3021	地番: 公共用地	
	画地境界線	
	街区番号	

事業名	北中振士地区画整理事業
図面名称	換地図その2 (換地処分後の土地図)
縮尺	1:500 (A3)
図面番号	
計画機関	

基図: 北中振士地区画整理事業出来形確認測量図
(令和7年4月23日 有限会社 第一測量調査事務所作成)

2025. 10. 08

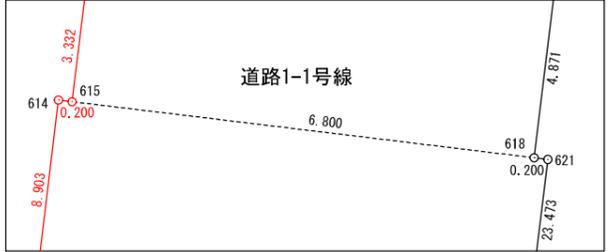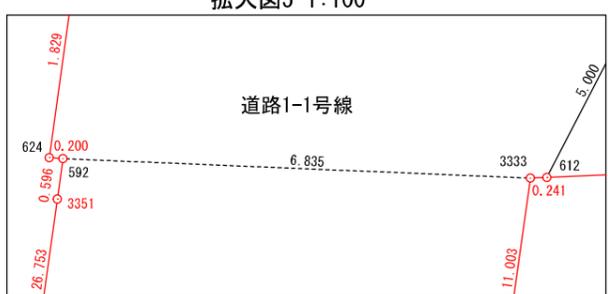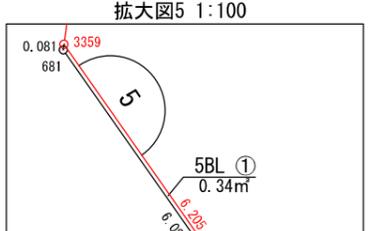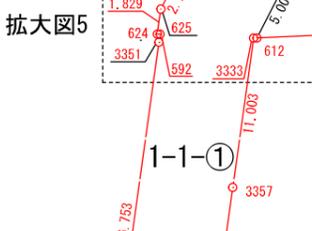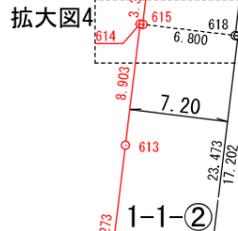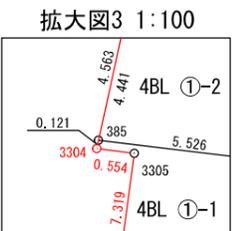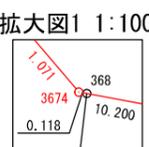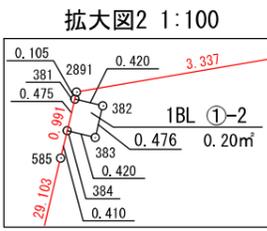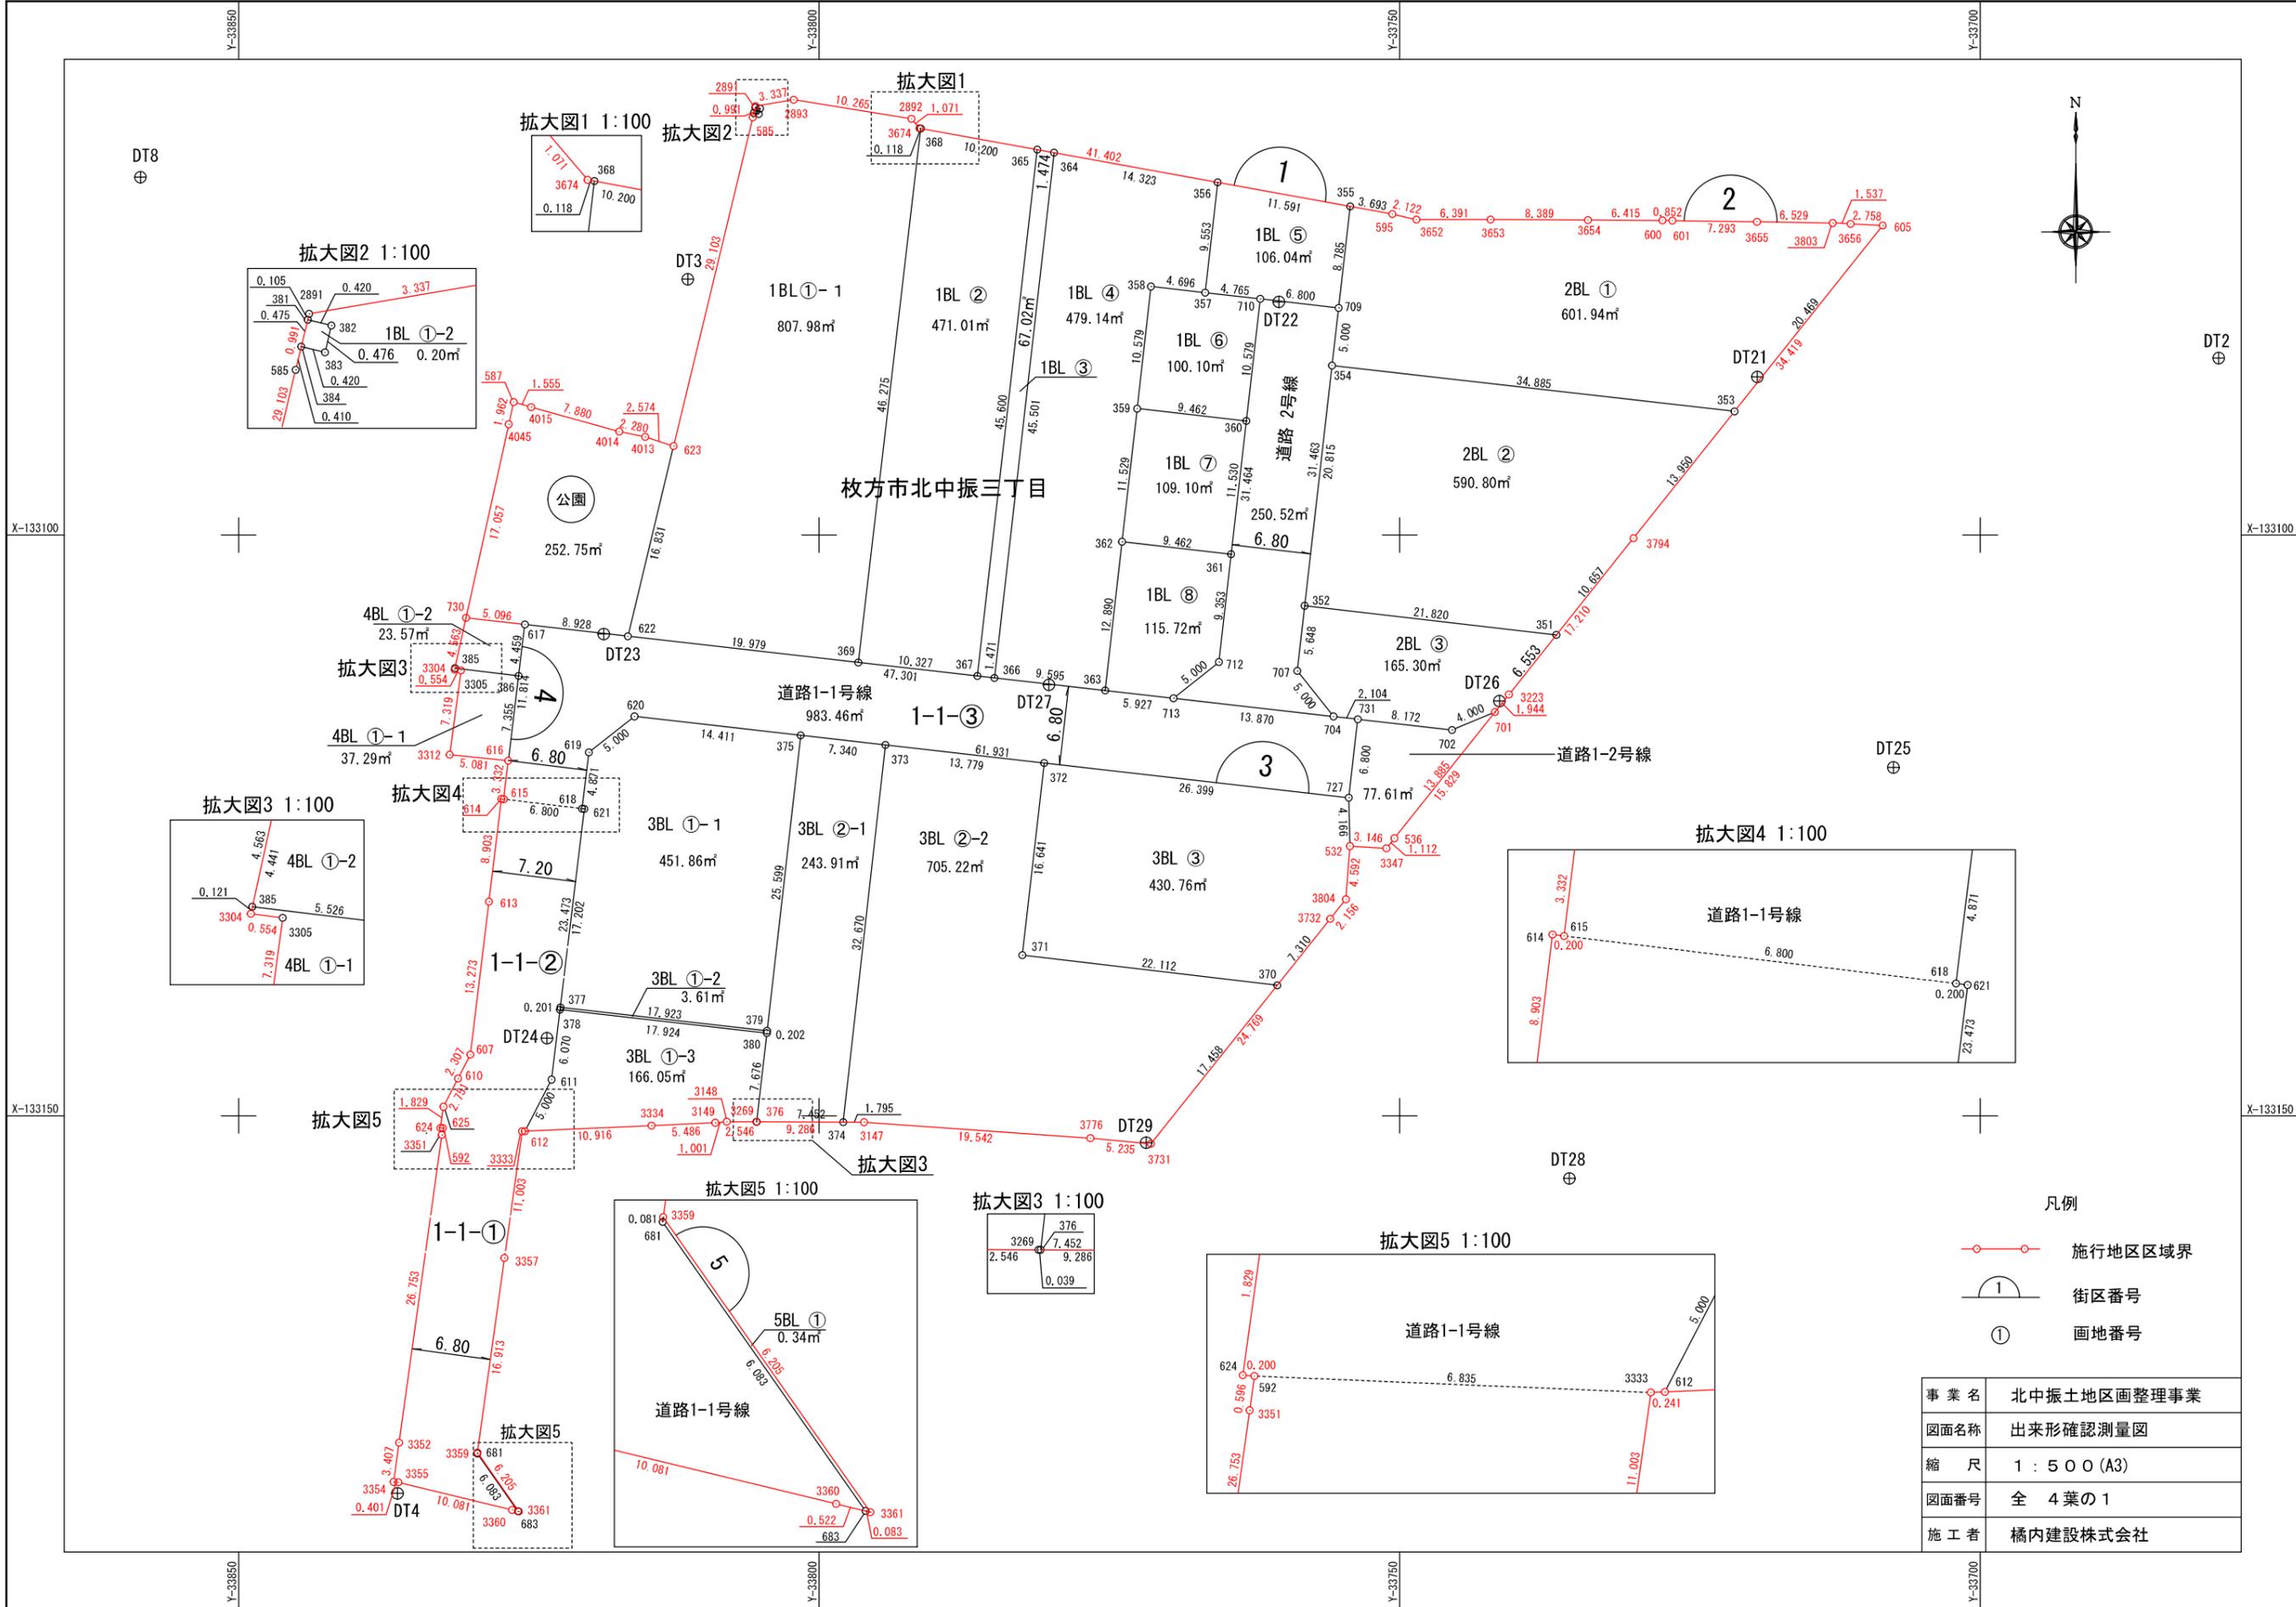

- 凡例
- 施行地区区域界
 - 街区番号
 - 画地番号

事業名	北中振土地区画整理事業
図面名称	出来形確認測量図
縮尺	1 : 500 (A3)
図面番号	全 4葉の 1
施工者	橋内建設株式会社

区域全体

N O	X	Y	辺長
605	-133073.349	-33708.394	
3656	-133073.213	-33711.149	2.758
3803	-133073.144	-33712.685	1.537
3655	-133073.035	-33719.214	6.529
601	-133072.935	-33726.507	7.293
600	-133072.921	-33727.359	0.852
3654	-133072.891	-33733.774	6.415
3653	-133072.850	-33742.163	8.389
3652	-133072.846	-33748.554	6.391
595	-133072.375	-33750.624	2.122
3674	-133064.982	-33791.361	41.402
2892	-133064.165	-33792.054	1.071
2893	-133062.525	-33802.188	10.265
2891	-133063.088	-33805.478	3.337
585	-133064.052	-33805.710	0.991
623	-133092.345	-33812.530	29.103
4013	-133091.560	-33814.982	2.574
4014	-133091.091	-33817.214	2.280
4015	-133088.992	-33824.810	7.880
587	-133088.553	-33826.302	1.555
4045	-133090.469	-33826.726	1.962
3304	-133111.580	-33831.394	21.620
3305	-133111.651	-33830.844	0.554
3312	-133118.905	-33831.822	7.319
616	-133119.428	-33826.767	5.081
615	-133122.736	-33827.168	3.332
614	-133122.712	-33827.367	0.200
613	-133131.551	-33828.439	8.903
607	-133144.728	-33830.038	13.273
610	-133146.778	-33831.097	2.307
625	-133149.222	-33832.360	2.751
624	-133151.034	-33832.612	1.829
592	-133151.050	-33832.412	0.200
3351	-133151.641	-33832.494	0.596
3352	-133178.140	-33836.176	26.753
3354	-133181.515	-33836.645	3.407
3355	-133181.556	-33836.246	0.401
3360	-133183.924	-33826.447	10.081
683	-133184.046	-33825.939	0.522
681	-133179.068	-33829.436	6.083
3359	-133178.987	-33829.425	0.081
3357	-133162.234	-33827.097	16.913
3333	-133151.335	-33825.582	11.003
612	-133151.324	-33825.341	0.241
611	-133146.882	-33823.045	5.000
621	-133123.579	-33820.218	23.473
618	-133123.554	-33820.417	0.200
619	-133118.718	-33819.830	4.871
620	-133115.617	-33815.907	5.000
727	-133122.613	-33754.372	61.931
731	-133115.856	-33753.602	6.800
面積			983.4636935
地積			983.46 m ²
605	-133073.349	-33708.394	34.419
面積			7241.4151895
地積			7241.41 m ²

路線名1-1号線

N O	X	Y	辺長
731	-133115.856	-33753.602	
704	-133115.619	-33755.693	2.104
713	-133114.052	-33769.475	13.870
622	-133108.708	-33816.474	47.301
617	-133107.699	-33825.345	8.928
616	-133119.428	-33826.767	11.814
615	-133122.736	-33827.168	3.332
614	-133122.712	-33827.367	0.200
613	-133131.551	-33828.439	8.903
607	-133144.728	-33830.038	13.273
610	-133146.778	-33831.097	2.307
625	-133149.222	-33832.360	2.751
624	-133151.034	-33832.612	1.829
592	-133151.050	-33832.412	0.200
3351	-133151.641	-33832.494	0.596
3352	-133178.140	-33836.176	26.753
3354	-133181.515	-33836.645	3.407
3355	-133181.556	-33836.246	0.401
3360	-133183.924	-33826.447	10.081
683	-133184.046	-33825.939	0.522
681	-133179.068	-33829.436	6.083
3359	-133178.987	-33829.425	0.081
3357	-133162.234	-33827.097	16.913
3333	-133151.335	-33825.582	11.003
612	-133151.324	-33825.341	0.241
611	-133146.882	-33823.045	5.000
621	-133123.579	-33820.218	23.473
618	-133123.554	-33820.417	0.200
619	-133118.718	-33819.830	4.871
620	-133115.617	-33815.907	5.000
727	-133122.613	-33754.372	61.931
731	-133115.856	-33753.602	6.800
面積			983.4636935
地積			983.46 m ²

路線名1-2号線

N O	X	Y	辺長
701	-133115.242	-33741.789	
702	-133116.780	-33745.482	4.000
731	-133115.856	-33753.602	8.172
727	-133122.613	-33754.372	6.800
532	-133126.778	-33754.275	4.166
3347	-133126.972	-33751.134	3.146
536	-133126.102	-33750.441	1.112
701	-133115.242	-33741.789	13.885
面積			77.6127755
地積			77.61 m ²

路線名 2号線

N O	X	Y	辺長
709	-133080.444	-33755.251	
710	-133079.675	-33762.008	6.800
712	-133110.938	-33765.563	31.464
713	-133114.052	-33769.475	5.000
704	-133115.619	-33755.693	13.870
707	-133111.706	-33758.806	5.000
709	-133080.444	-33755.251	31.463
面積			250.5210345
地積			250.52 m ²

公園

N O	X	Y	辺長
623	-133092.345	-33812.530	
4013	-133091.560	-33814.982	2.574
4014	-133091.091	-33817.214	2.280
4015	-133088.992	-33824.810	7.880
587	-133088.553	-33826.302	1.555
4045	-133090.469	-33826.726	1.962
730	-133107.124	-33830.409	17.057
617	-133107.699	-33825.345	5.096
622	-133108.708	-33816.474	8.928
623	-133092.345	-33812.530	16.831
面積			252.7515770
地積			252.75 m ²

事業名	北中振土地区画整理事業
図面名称	出来形確認測量図
縮尺	
図面番号	
施工者	橋内建設株式会社

道路1-1-①

N O	X	Y	辺長
3333	-133151.335	-33825.582	
592	-133151.050	-33832.412	6.835
3351	-133151.641	-33832.494	0.596
3352	-133178.140	-33836.176	26.753
3354	-133181.515	-33836.645	3.407
3355	-133181.556	-33836.246	0.401
3360	-133183.924	-33826.447	10.081
683	-133184.046	-33825.939	0.522
681	-133179.068	-33829.436	6.083
3359	-133178.987	-33829.425	0.081
3357	-133162.234	-33827.097	16.913
3333	-133151.335	-33825.582	11.003
面積	221.8195150		

道路1-1-③

N O	X	Y	辺長
731	-133115.856	-33753.602	
704	-133115.619	-33755.693	2.104
713	-133114.052	-33769.475	13.870
622	-133108.708	-33816.474	47.301
617	-133107.699	-33825.345	8.928
616	-133119.428	-33826.767	11.814
615	-133122.736	-33827.168	3.332
618	-133123.554	-33820.417	6.800
619	-133118.718	-33819.830	4.871
620	-133115.617	-33815.907	5.000
727	-133122.613	-33754.372	61.931
731	-133115.856	-33753.602	6.800
面積	554.3258985		

道路1-1-②

N O	X	Y	辺長
621	-133123.579	-33820.218	
618	-133123.554	-33820.417	0.200
615	-133122.736	-33827.168	6.800
614	-133122.712	-33827.367	0.200
613	-133131.551	-33828.439	8.903
607	-133144.728	-33830.038	13.273
610	-133146.778	-33831.097	2.307
625	-133149.222	-33832.360	2.751
624	-133151.034	-33832.612	1.829
592	-133151.050	-33832.412	0.200
3333	-133151.335	-33825.582	6.835
612	-133151.324	-33825.341	0.241
611	-133146.882	-33823.045	5.000
621	-133123.579	-33820.218	23.473
面積	207.3182800		

事業名	北中振土地区画整理事業
図面名称	出来形確認測量図
縮尺	
図面番号	
施工者	橋内建設株式会社

1BL ①-1

N O	X	Y	辺長
2891	-133063.088	-33805.478	
381	-133063.191	-33805.503	0.105
382	-133063.289	-33805.094	0.420
383	-133063.752	-33805.205	0.476
384	-133063.653	-33805.614	0.420
585	-133064.052	-33805.710	0.410
623	-133092.345	-33812.530	29.103
622	-133108.708	-33816.474	16.831
369	-133110.965	-33796.622	19.979
368	-133065.003	-33791.244	46.275
3674	-133064.982	-33791.361	0.118
2892	-133064.165	-33792.054	1.071
2893	-133062.525	-33802.188	10.265
2891	-133063.088	-33805.478	3.337
面積	807.9884255		
地積	807.98 m ²		

1BL ①-2

N O	X	Y	辺長
381	-133063.191	-33805.503	
384	-133063.653	-33805.614	0.475
383	-133063.752	-33805.205	0.420
382	-133063.289	-33805.094	0.476
381	-133063.191	-33805.503	0.420
面積	0.2000960		
地積	0.20 m ²		

1BL ②

N O	X	Y	辺長
368	-133065.003	-33791.244	
369	-133110.965	-33796.622	46.275
367	-133112.132	-33786.361	10.327
365	-133066.824	-33781.207	45.600
368	-133065.003	-33791.244	10.200
面積	471.0170190		
地積	471.01 m ²		

1BL ③

N O	X	Y	辺長
365	-133066.824	-33781.207	
367	-133112.132	-33786.361	45.600
366	-133112.298	-33784.899	1.471
364	-133067.088	-33779.756	45.501
365	-133066.824	-33781.207	1.474
面積	67.0266610		
地積	67.02 m ²		

1BL ④

N O	X	Y	辺長
364	-133067.088	-33779.756	
366	-133112.298	-33784.899	45.501
363	-133113.382	-33775.365	9.595
362	-133100.574	-33773.908	12.890
359	-133089.118	-33772.605	11.529
358	-133078.606	-33771.409	10.579
357	-133079.137	-33766.743	4.696
356	-133069.645	-33765.663	9.553
364	-133067.088	-33779.756	14.323
面積	479.1433115		
地積	479.14 m ²		

1BL ⑤

N O	X	Y	辺長
356	-133069.645	-33765.663	
357	-133079.137	-33766.743	9.553
710	-133079.675	-33762.008	4.765
709	-133080.444	-33755.251	6.800
355	-133071.715	-33754.258	8.785
356	-133069.645	-33765.663	11.591
面積	106.0487150		
地積	106.04 m ²		

1BL ⑥

N O	X	Y	辺長
358	-133078.606	-33771.409	
359	-133089.118	-33772.605	10.579
360	-133090.187	-33763.203	9.462
710	-133079.675	-33762.008	10.579
357	-133079.137	-33766.743	4.765
358	-133078.606	-33771.409	4.696
面積	100.1045690		
地積	100.10 m ²		

1BL ⑦

N O	X	Y	辺長
359	-133089.118	-33772.605	
362	-133100.574	-33773.908	11.529
361	-133101.644	-33764.506	9.462
360	-133090.187	-33763.203	11.530
359	-133089.118	-33772.605	9.462
面積	109.1075715		
地積	109.10 m ²		

1BL ⑧

N O	X	Y	辺長
362	-133100.574	-33773.908	
363	-133113.382	-33775.365	12.890
713	-133114.052	-33769.475	5.927
712	-133110.938	-33765.563	5.000
361	-133101.644	-33764.506	9.353
362	-133100.574	-33773.908	9.462
面積	115.7293930		
地積	115.72 m ²		

2BL ①

N O	X	Y	辺長
355	-133071.715	-33754.258	
709	-133080.444	-33755.251	8.785
354	-133085.412	-33755.816	5.000
353	-133089.355	-33721.154	34.885
605	-133073.349	-33708.394	20.469
3656	-133073.213	-33711.149	2.758
3803	-133073.144	-33712.685	1.537
3655	-133073.035	-33719.214	6.529
601	-133072.935	-33726.507	7.293
600	-133072.921	-33727.359	0.852
3654	-133072.891	-33733.774	6.415
3653	-133072.850	-33742.163	8.389
3652	-133072.846	-33748.554	6.391
595	-133072.375	-33750.624	2.122
355	-133071.715	-33754.258	3.693
面積	601.9407485		
地積	601.94 m ²		

2BL ②

N O	X	Y	辺長
354	-133085.412	-33755.816	
352	-133106.094	-33758.168	20.815
351	-133108.597	-33736.492	21.820
3794	-133100.263	-33729.850	10.657
353	-133089.355	-33721.154	13.950
354	-133085.412	-33755.816	34.885
面積	590.8062490		
地積	590.80 m ²		

事業名	北中振土地区画整理事業
図面名称	出来形確認測量図
縮尺	
図面番号	
施工者	橋内建設株式会社

2BL ③

N O	X	Y	辺長
352	-133106.094	-33758.168	
707	-133111.706	-33758.806	5.648
704	-133115.619	-33755.693	5.000
731	-133115.856	-33753.602	2.104
702	-133116.780	-33745.482	8.172
701	-133115.242	-33741.789	4.000
3223	-133113.722	-33740.577	1.944
351	-133108.597	-33736.492	6.553
352	-133106.094	-33758.168	21.820
面積	165.3087415		
地積	165.30 m ²		

3BL ①-3

N O	X	Y	辺長
378	-133140.856	-33822.314	
611	-133146.882	-33823.045	6.070
612	-133151.324	-33825.341	5.000
3334	-133150.839	-33814.435	10.916
3149	-133150.595	-33808.954	5.486
3148	-133150.497	-33807.957	1.001
3269	-133150.509	-33805.411	2.546
376	-133150.509	-33805.372	0.039
380	-133142.882	-33804.504	7.676
378	-133140.856	-33822.314	17.924
面積	166.0556440		
地積	166.05 m ²		

3BL ③

N O	X	Y	辺長
372	-133119.631	-33780.603	
371	-133136.165	-33782.491	16.641
370	-133138.759	-33760.531	22.112
3732	-133133.044	-33755.972	7.310
3804	-133131.357	-33754.628	2.156
532	-133126.778	-33754.275	4.592
727	-133122.613	-33754.372	4.166
372	-133119.631	-33780.603	26.399
面積	430.7606885		
地積	430.76 m ²		

4BL ①-2

N O	X	Y	辺長
730	-133107.124	-33830.409	
385	-133111.461	-33831.368	4.441
386	-133112.126	-33825.882	5.526
617	-133107.699	-33825.345	4.459
730	-133107.124	-33830.409	5.096
面積	23.5788100		
地積	23.57 m ²		

3BL ①-1

N O	X	Y	辺長
619	-133118.718	-33819.830	
618	-133123.554	-33820.417	4.871
621	-133123.579	-33820.218	0.200
377	-133140.656	-33822.290	17.202
379	-133142.681	-33804.481	17.923
375	-133117.245	-33801.588	25.599
620	-133115.617	-33815.907	14.411
619	-133118.718	-33819.830	5.000
面積	451.8691255		
地積	451.86 m ²		

3BL ②-1

N O	X	Y	辺長
375	-133117.245	-33801.588	
379	-133142.681	-33804.481	25.599
380	-133142.882	-33804.504	0.202
376	-133150.509	-33805.372	7.676
374	-133150.543	-33797.920	7.452
373	-133118.074	-33794.294	32.670
375	-133117.245	-33801.588	7.340
面積	243.9153525		
地積	243.91 m ²		

4BL ①-1

N O	X	Y	辺長
385	-133111.461	-33831.368	
3304	-133111.580	-33831.394	0.121
3305	-133111.651	-33830.844	0.554
3312	-133118.905	-33831.822	7.319
616	-133119.428	-33826.767	5.081
386	-133112.126	-33825.882	7.355
385	-133111.461	-33831.368	5.526
面積	37.2972695		
地積	37.29 m ²		

5BL ①

N O	X	Y	辺長
3359	-133178.987	-33829.425	
681	-133179.068	-33829.436	0.081
683	-133184.046	-33825.939	6.083
3361	-133184.065	-33825.858	0.083
3359	-133178.987	-33829.425	6.205
面積	0.3407800		
地積	0.34 m ²		

3BL ①-2

N O	X	Y	辺長
377	-133140.656	-33822.290	
378	-133140.856	-33822.314	0.201
380	-133142.882	-33804.504	17.924
379	-133142.681	-33804.481	0.202
377	-133140.656	-33822.290	17.923
面積	3.6184040		
地積	3.61 m ²		

3BL ②-2

N O	X	Y	辺長
373	-133118.074	-33794.294	
374	-133150.543	-33797.920	32.670
3147	-133150.551	-33796.125	1.795
3776	-133151.922	-33776.631	19.542
3731	-133152.407	-33771.418	5.235
370	-133138.759	-33760.531	17.458
371	-133136.165	-33782.491	22.112
372	-133119.631	-33780.603	16.641
373	-133118.074	-33794.294	13.779
面積	705.2255610		
地積	705.22 m ²		

事業名	北中振土地区画整理事業
図面名称	出来形確認測量図
縮尺	
図面番号	---
施工者	橋内建設株式会社